



# 松戸市河原塚宮ノ内土地区画整理事業


## 画地出来形確認測量図

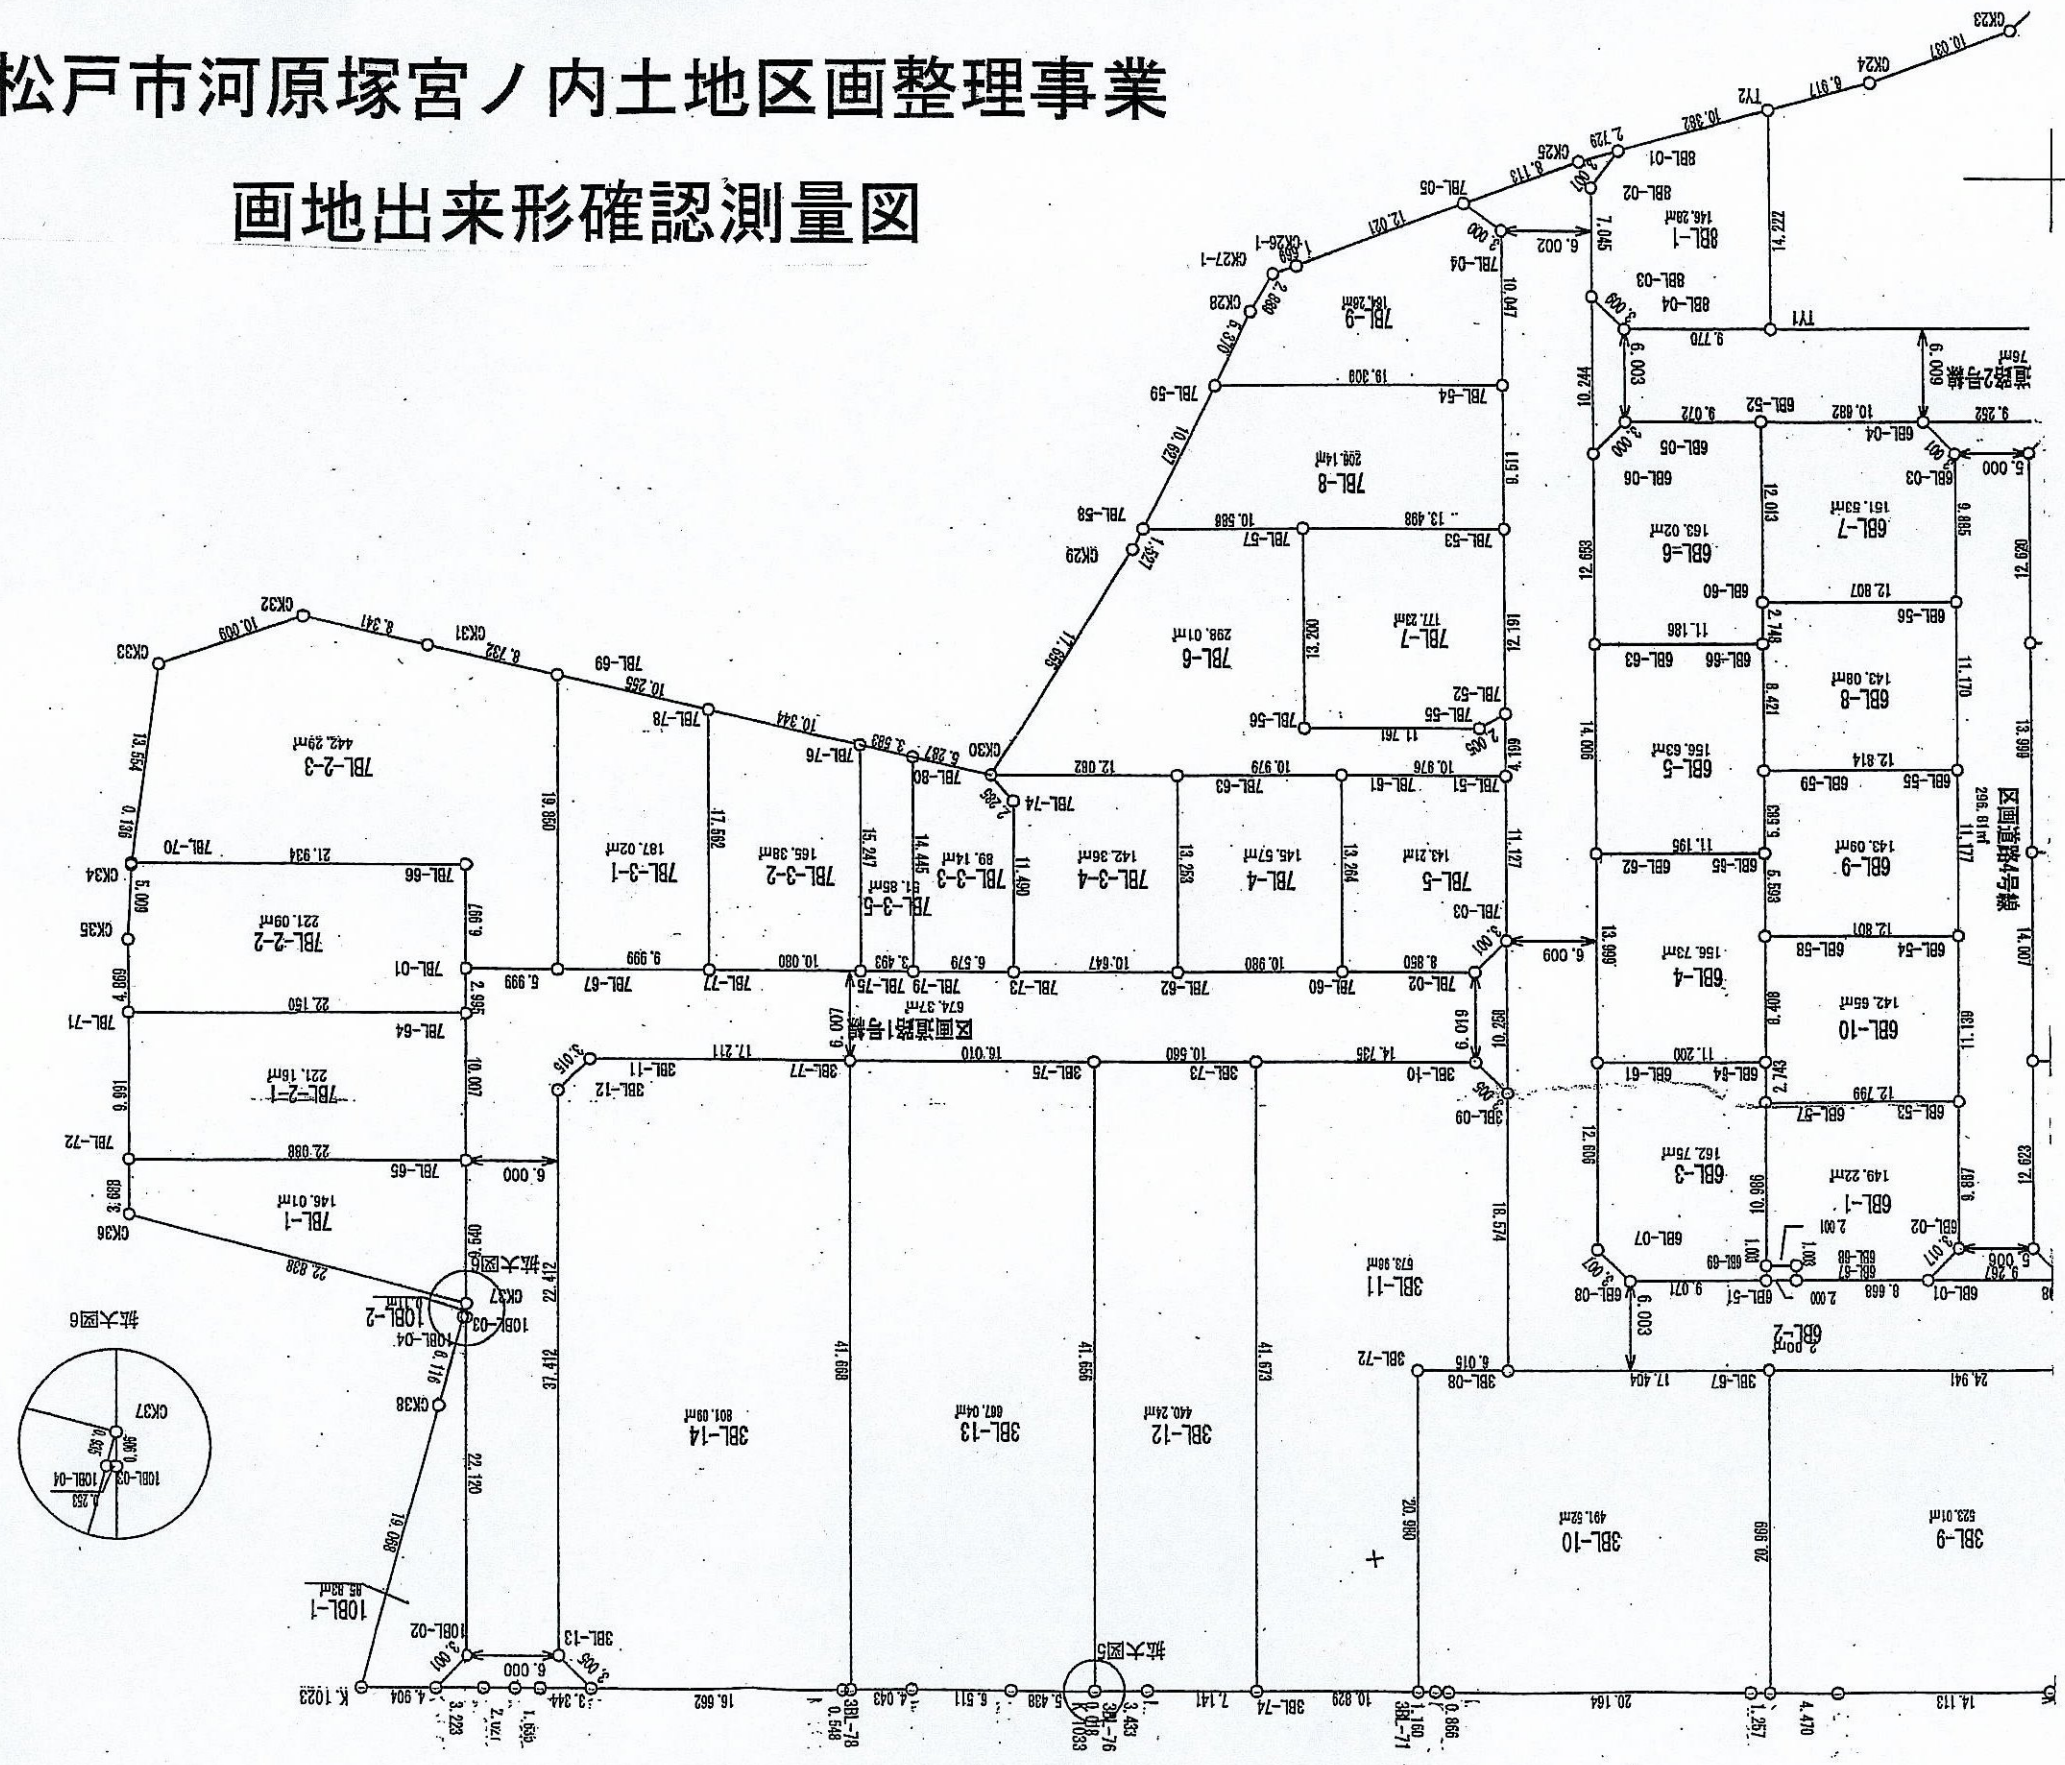

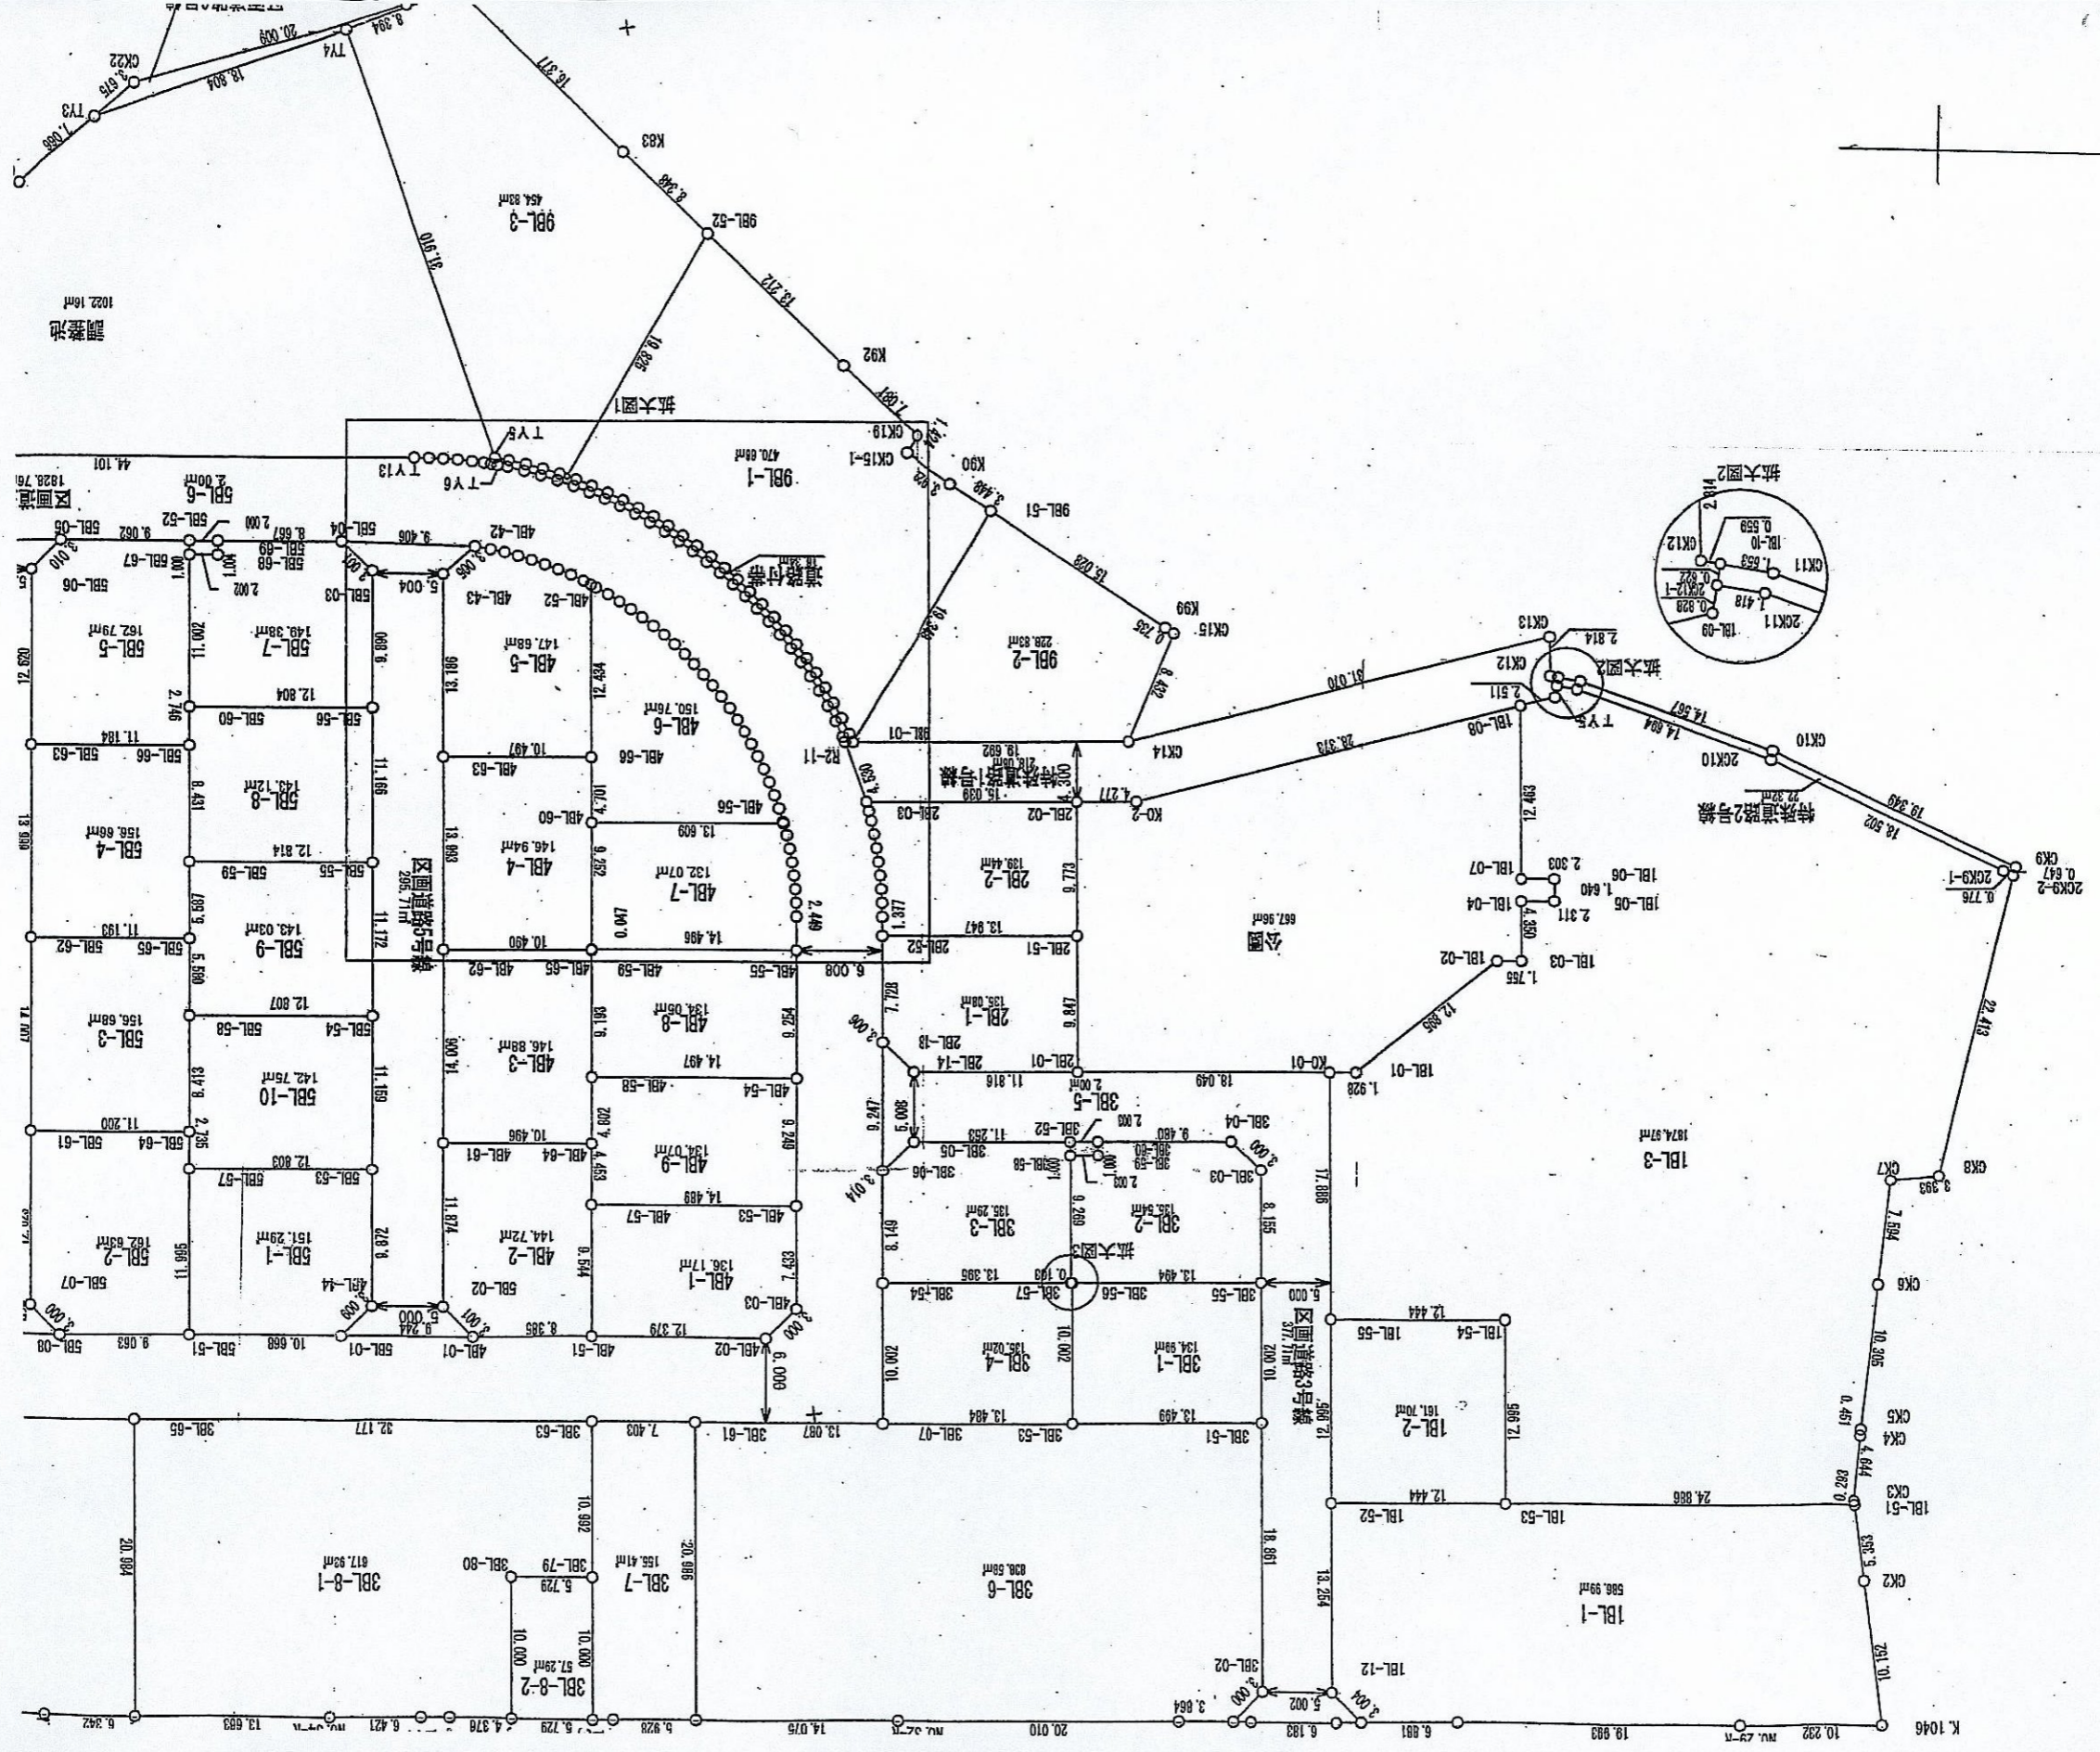

1022 16m  
1828.76  
区画道

扩大图1

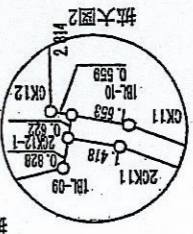

扩大图2

扩大图3

扩大图3

K. 1046 10.292 19.893 6.891 6.183 5.002 3.864 20.010 14.076 5.928 4.376 5.729 13.683 6.421 6.421 20.984 9.242 10.292 19.893 6.891 6.183 5.002 3.864 20.010 14.076 5.928 4.376 5.729 13.683 6.421 6.421 20.984 9.242